



CENTURY


LIGHTING | ART | DESIGN

joekrauslighting

301-537-5808

joe@joekrauslighting.com

www.joekrauslighting.com

A long, dark linear bar fixture is suspended from a ceiling, featuring a series of cylindrical light shades. The fixture is composed of a dark, rectangular bar with several cylindrical shades attached to its top surface. The shades are illuminated from within, casting a warm, yellowish glow. The fixture is suspended by a single dark rod on the left and a pair of dark rods on the right. The background shows a modern interior with a dark wood ceiling, a light-colored wall, and a dark wood shelving unit on the left. The overall aesthetic is contemporary and minimalist.

Custom Linear Bar Fixture - 144"



AA: APPROVED AS NOTED



NOTES:

- 1) METAL: ALL EXPOSED METAL FINISH TO BE POWDER COATED MATTE BLACK
 - 2) SHADE: FROSTED CLEAR ACRYLIC
 - 3) LAMPING: INTEGRATED LED 24W, NON DIMMABLE, W/DRIVER@CANOPY
 - 4) HARD WIRED. SUITABLE FOR INDOOR(DRY) LOCATION USE. 120V. A.C. 60Hz
 - 5) UL/CUL APPROVED
- ***APPROX MAX. WEIGHTS: 25LBS

Please provide Dimmable

AA: All parts & pieces to have Black finish


AA: Coordinate mounting height in field with designer

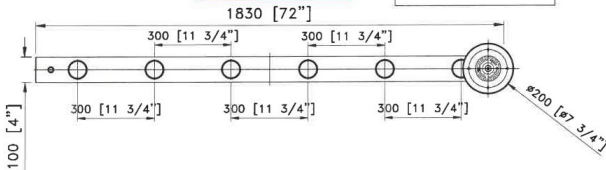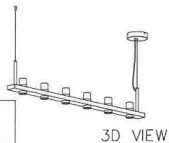

TOP VIEW

SCALE: 1:15

TO BE VERIFIED IN FIELD

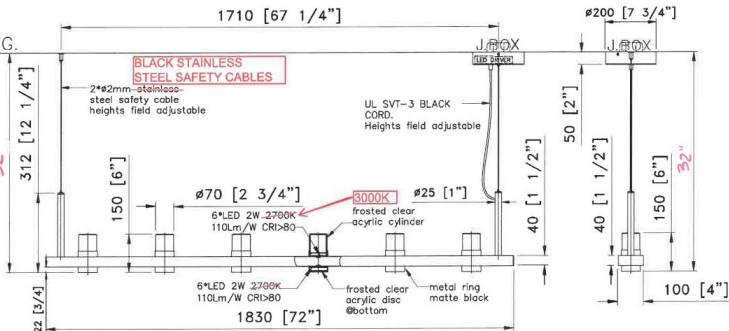

FRONT VIEW

SCALE: 1:15

SIDE VIEW

SCALE: 1:15

CUSTOM BAR DIRECT/INDIRECT LIGHTING PENDANT

ITEM NO:K8 QTY:2X

Approval: Date: _____

With comments: _____

Signed By: _____

Estimated Leads time are contingent upon receiving approved submittals and are subject to change

Brightview Senior Living

North Fairfax, VA

Les Industries CENTURY Industries Inc.

5645 Royalmount Ave.

Montreal, Quebec, Canada H4P 2P9

Tel:514-842-3933 Fax:514-842-7481

Toll free Canada only:1-877-842-3934

Date: 2024/03/11 Rev: _____

(yyyy/mm/dd)

(yyyy/mm/dd)

Dwg. #

P 1/1